



Wildlife & Countryside Act 1981  
Definitive Map and Statement of Public Rights of  
Way for Warwickshire

form

1

### Application for a Modification Order

Rights of Way, Communities,  
PO Box 43, Shire Hall,  
Warwick, CV34 4SX

To: Warwickshire County Council *Rights of Way, Communities,*  
Of: PO Box 43, Shire Hall, Warwick, CV34 4SX  
I/we: *Clr. Neil F. J. Thurley FRICS*  
Of: *The Elms, Village Road, Wasperton, Warwick CV35 8EB*

hereby apply for an Order under Section 53(2) of the Wildlife and Countryside Act 1981  
modifying the Definitive Map and Statement for the County of Warwick by

~~Deleting~~ \* the Footpath / Bridleway / Restricted Byway / Byway Open to all Traffic \*

~~from~~ ..... ~~to~~ .....

Adding \* the Footpath / Bridleway / Restricted Byway / Byway Open to all Traffic \*

from *426695 258810* to *426545 258815*

~~Upgrading / Downgrading~~ \* to a Footpath / Bridleway / Restricted Byway / Byway Open to all  
Traffic \* ~~the Footpath / Bridleway / Restricted Byway / Byway Open to all Traffic \*~~

~~from~~ ..... ~~to~~ .....

~~Varying / Adding to~~ \* the particulars relating to the Footpath / Bridleway / Restricted Byway /  
Byway Open to all Traffic \*

~~from~~ ..... ~~to~~ .....

by providing that .....

\* delete as appropriate


and shown on the map accompanying this application. (*Ordnance Survey location Plan*)

I/we attach copies of the following documentary evidence (including statements of witnesses)  
in support of this application (see overleaf \*\*).

Dated *21 May 2013*

:25000 or greater (e.g. 1:10000)

Please see overleaf

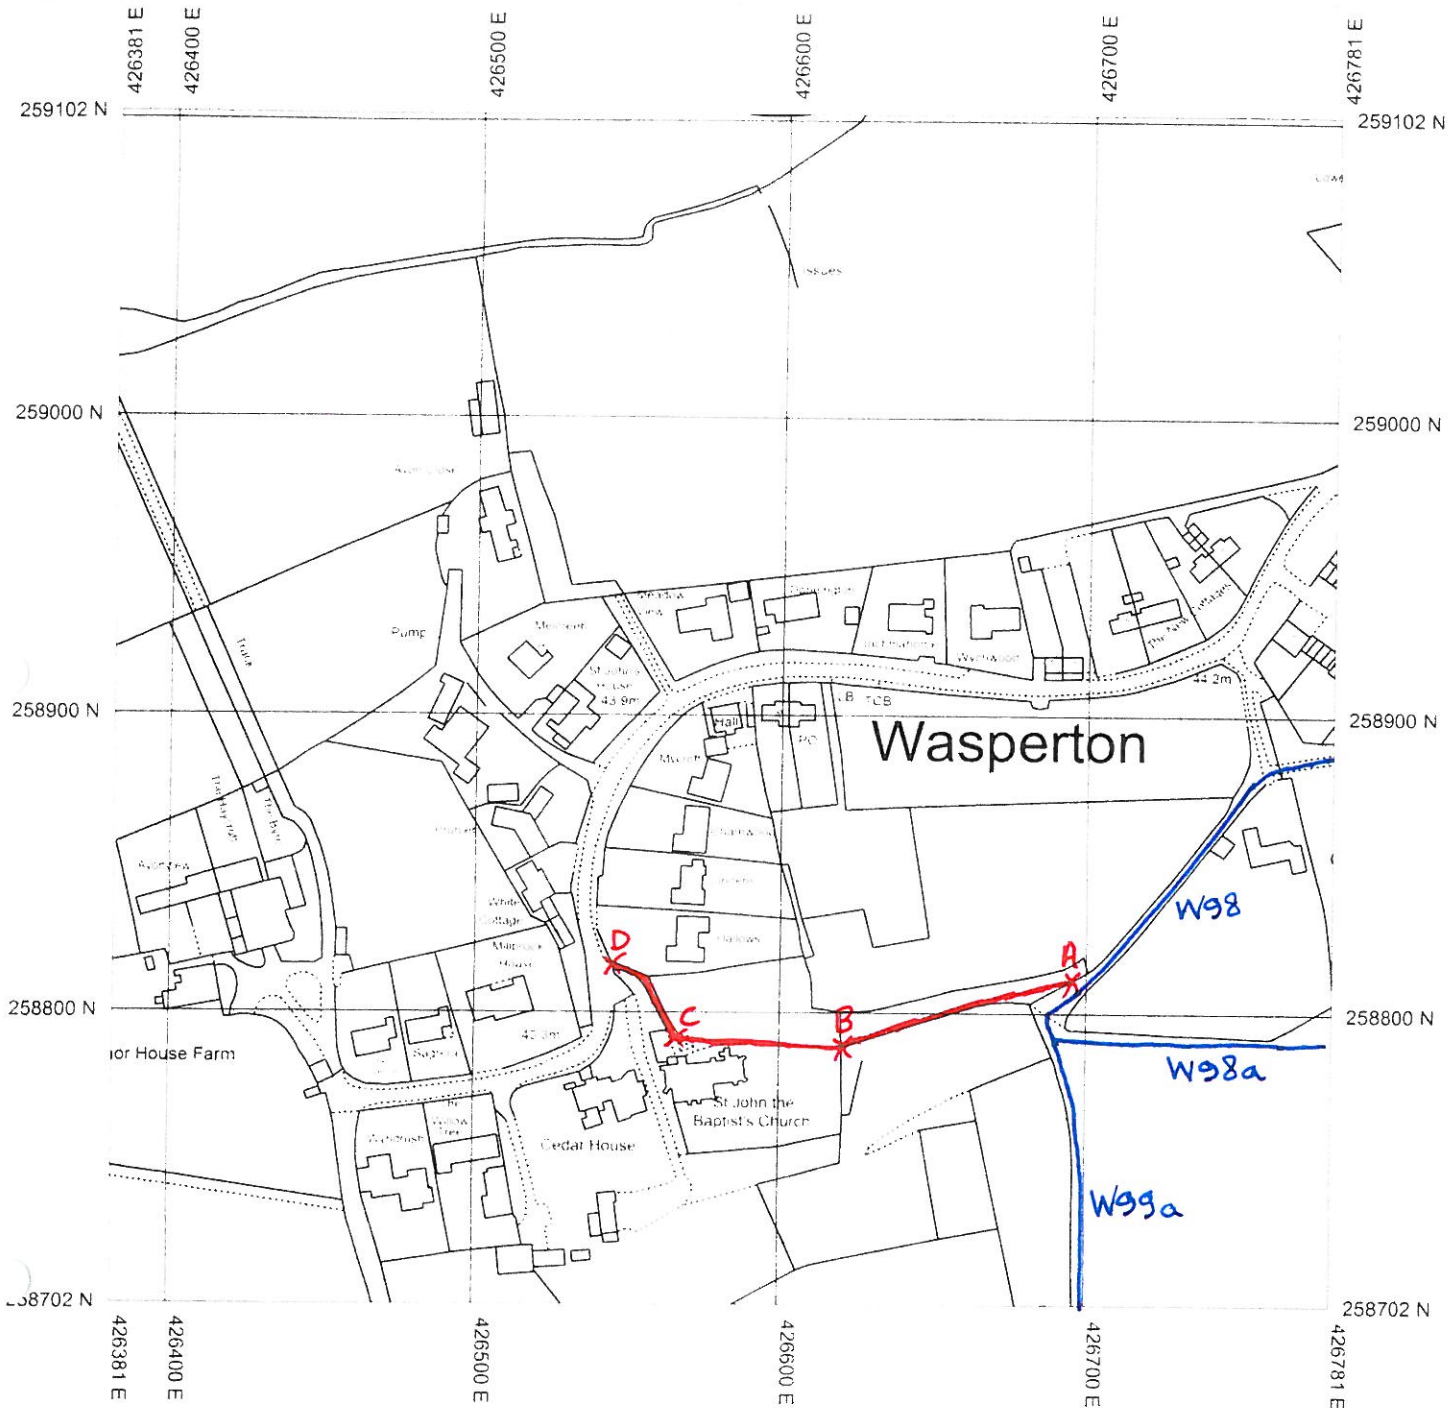

Produced 15/05/2012 from the Ordnance Survey  
National Geographic Database and incorporating  
surveyed revision available at this date. © Crown  
Copyright 2012

Reproduction in whole or in part is prohibited without  
the prior permission of Ordnance Survey

Ordnance Survey and the OS Symbol are registered  
trademarks of Ordnance Survey, the national mapping  
agency of Great Britain.


The representation of a road, track or path is no  
evidence of a right of way.

The representation of features as lines is no evidence  
of a property boundary.

A to B Compacted Natural Earth  
Trodden Path

B to C Trodden Grass Path

C to D Firm Gravelled Church Footpath

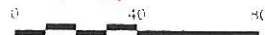

Scale 1:2500

Supplied By Mail Boxes Etc leamington

Serial number 001042113

Plot Centre Coordinates 426581, 258902

Hall

A - Steel Kissing Gate

B - Steel Pedestrian Gate

D - Steel Pedestrian Gate

Public Footpaths -

W98, 98a, W99a